

South Carolina Department of Health and Environmental Control
Division of Ocean and Coastal Resource Management
1362 McMillan Avenue, Suite 400
Charleston, South Carolina 29405

March 9, 2015
Permit Application Public Notice

Jan V. Dorn, OCRM-15-074-M

The Department has received an application for a permit for the alteration of a critical area. The application was submitted pursuant to the Coastal Zone Management Act (Act 123) of 1977 South Carolina General Assembly. The application in brief, is described as follows:


LOCATION: On and adjacent to Store Creek at 1499 Marsh Bluff Court, Edisto Island, Charleston County, South Carolina.
TMS: 625-00-00-038.

WORK: The work as proposed consist of making additions to an existing community dock. Specifically, the applicant seeks to add a 4' x 15' walkway, with handrails, leading to a covered 11.5' x 11.5', four-pile boatlift & 3' "L" shaped catwalk, with handrails. The new structure is proposed landward of the existing dock. The work as described is for additions to an existing community dock.

This public notice is being distributed to all known interested persons and agencies to assist in developing facts on which a decision by the Department can be based. Comments concerning the proposed work must be submitted in writing, setting forth sufficient detail to furnish a clear understanding of the reasons for support or opposition.


Comments regarding this application must be received by the Department on or before **April 8, 2015**. For more information, please contact:
Fred Mallett at 843-953-0236 or via email at mallettf@dhec.sc.gov.

NOTE: Plans depicting the proposed work are available and will be provided upon receipt of a written request or may be viewed on the Department website at <http://www.scdhec.gov/Apps/Environment/PublicNotices>.

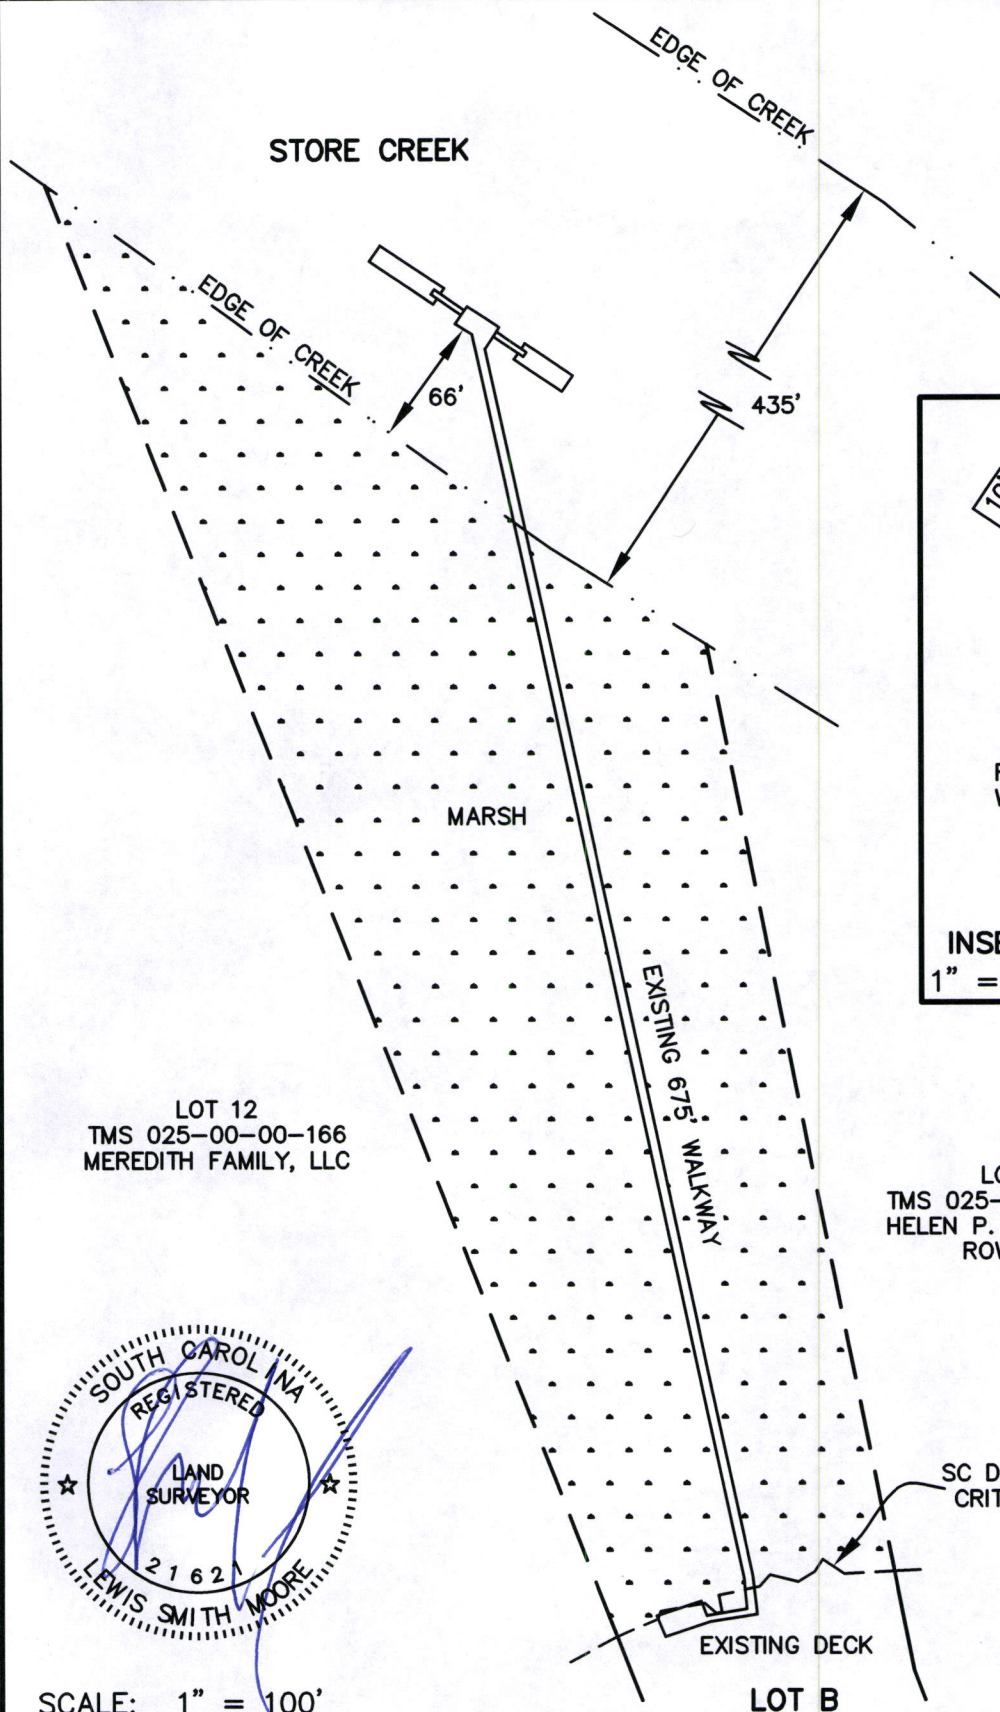

FIXED PIER CORNER A
N 263123.6617
E 2208248.8510

FIXED PIER CORNER B
N 263112.7872
E 2208265.3787

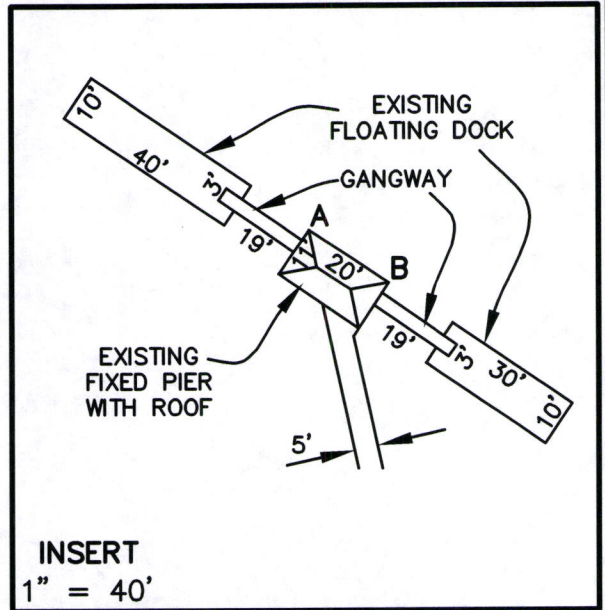


SCALE: 1" = 100'

RECEIVED
FEB 28 2015
DHEC-OCRM
CHARLESTON OFFICE

existing

SHEET: DOCK AS-BUILT
APPLICANT: JAN DORN
ACTIVITY: PRIVATE RECREATIONAL DOCK
LOCATION: STORE CREEK
P/N# OCRM-15-074-M

1499 MARSH BLUFF COURT
EDISTO ISLAND
CHARLESTON COUNTY
SOUTH CAROLINA
TMS 025-00-00-038

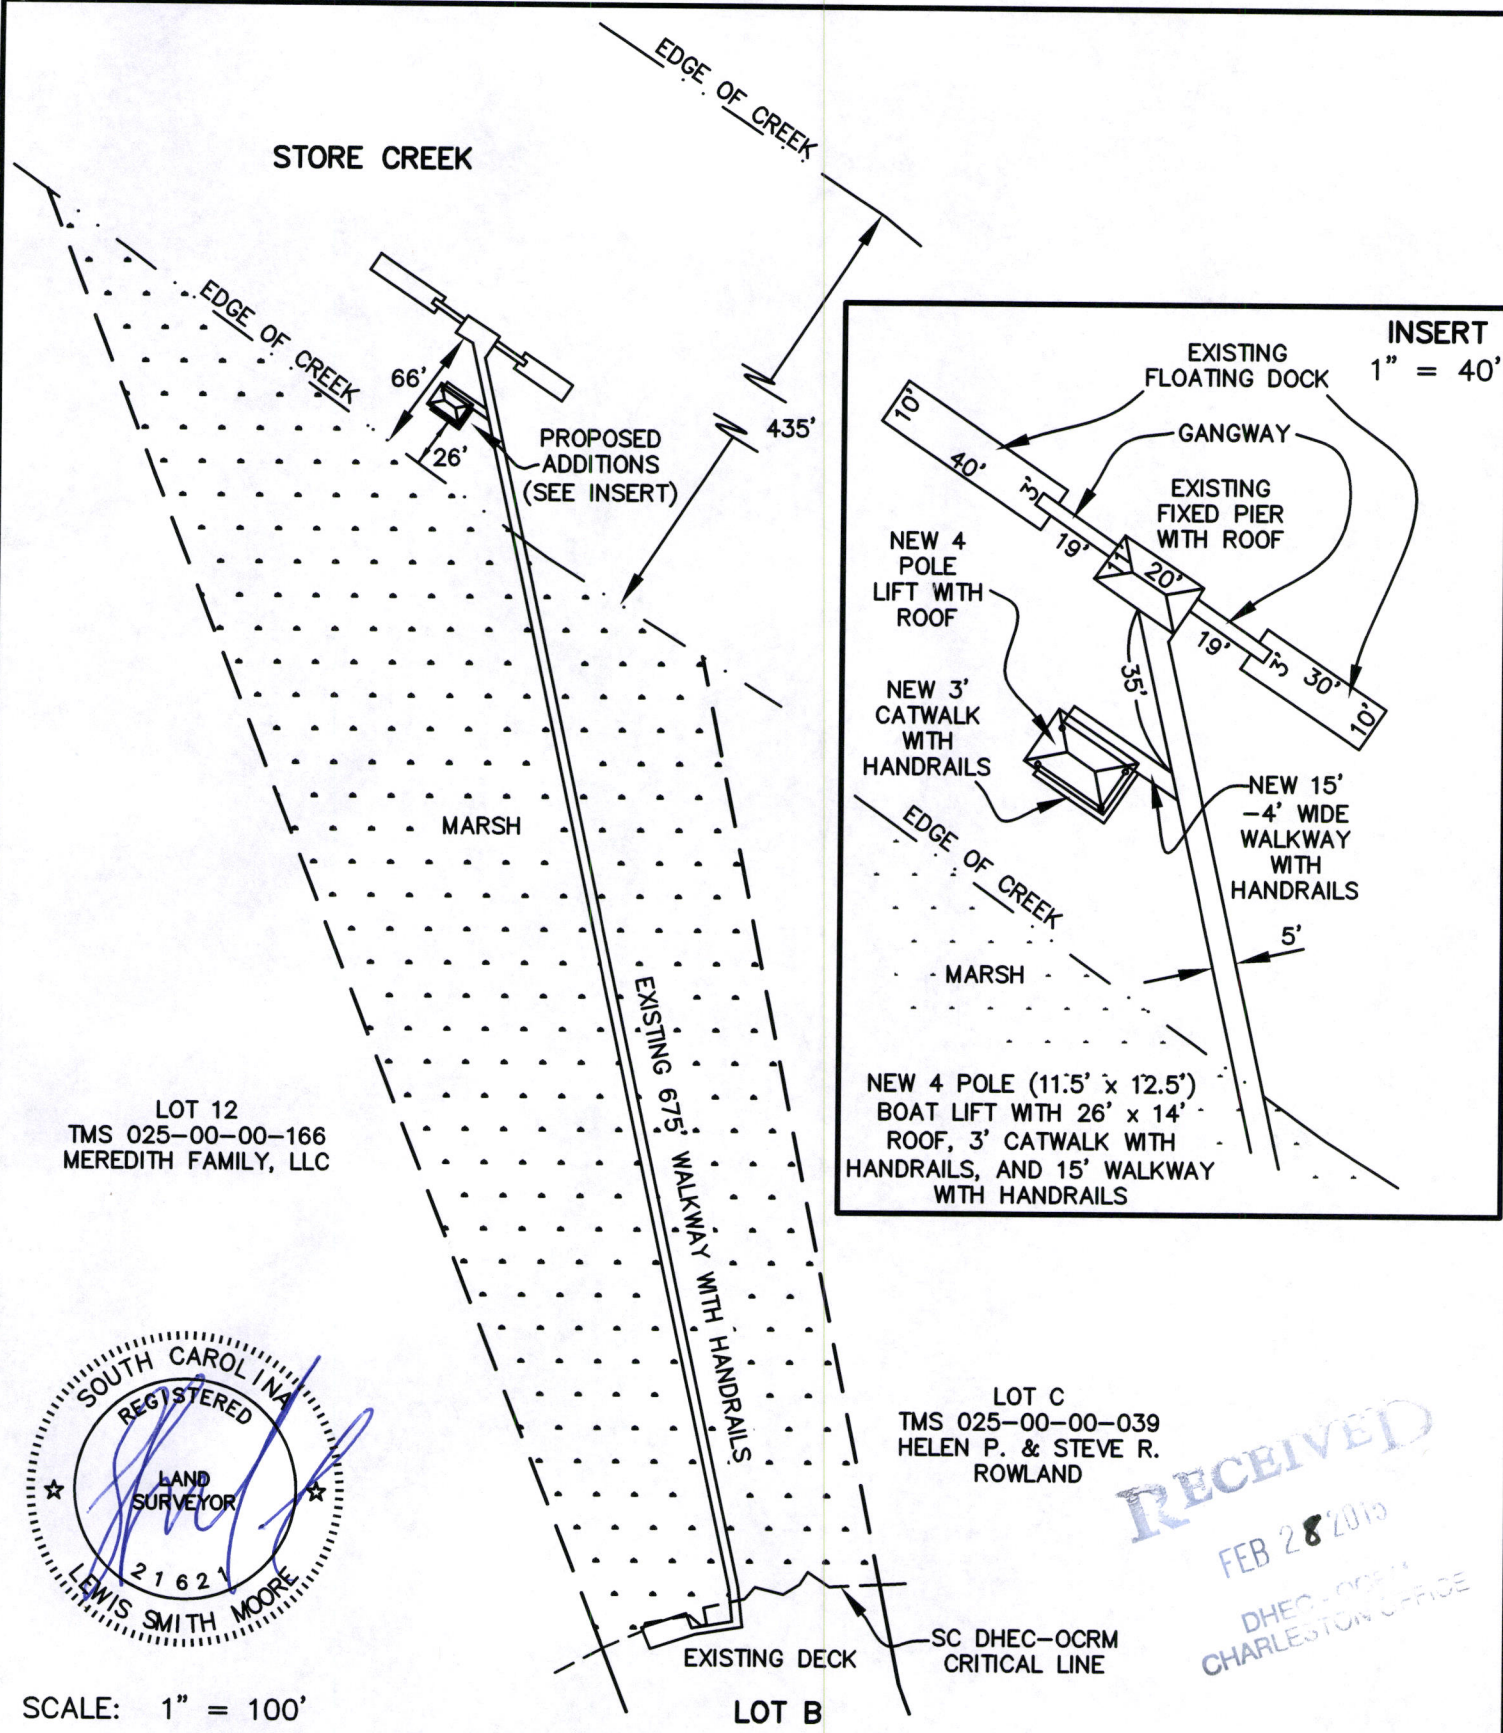

LOT 12
TMS 025-00-00-166
MEREDITH FAMILY, LLC



SCALE: 1" = 100'

LOT C
TMS 025-00-00-039
HELEN P. & STEVE R.
ROWLAND

RECEIVED
FEB 28 2019
DHEC-OCRM
CHARLESTON OFFICE

SC DHEC-OCRM
CRITICAL LINE

Proposed

SHEET:
APPLICANT: JAN DORN
ACTIVITY: PRIVATE RECREATIONAL DOCK
LOCATION: STORE CREEK
P/N# OCRM- 15-074-M

1499 MARSH BLUFF COURT
EDISTO ISLAND
CHARLESTON COUNTY
SOUTH CAROLINA
TMS 025-00-00-038

1499 Marsh Bluff Ct, Edisto Island, SC 29438

OCRM-15-074-M



On the go? Use m.bing.com to find maps, directions, businesses, and more

